

Outfall Chart
Section 'A'

NUMBER	DESCRIPTION	STATE PLANE COORDINATES	
		X	Y
DPW DETENTION BASIN	1 18" DIA. R.C.P. OUTFALL	334365.55	374381.13
	2 12" DIA. R.C.P. OUTFALL	334137.40	374177.93
	3 12" DIA. R.C.P. OUTFALL	334133.46	374165.62
DEERR FIELD OUTFALL	4 42" DIA. R.C.P. OUTFALL	334287.45	374078.86
	5 36" DIA. R.C.P. OUTFALL	336285.38	372746.42
	6 24" DIA. P.V.C. OUTFALL	336240.81	373479.04
	7 18" DIA. R.C.P. OUTFALL	336368.78	373497.95
CULVERT STONY BROOK	8 24" DIA. P.V.C. OUTFALL	336989.79	374266.95
	9 12" DIA. R.C.P. OUTFALL	337052.83	374212.40
E. WILLIAMS AVE. / BRIDGE CULVERT	10 28" DIA. R.C.P. OUTFALL	337480.41	374826.21
	11 24" DIA. R.C.P. OUTFALL	335254.98	379379.91
	12 21" DIA. R.C.P. OUTFALL	338051.66	378540.31
	13 12" DIA. H.D.P.E.P. OUTFALL	338115.21	378224.23
	14 54" DIA. R.C.P. OUTFALL	338021.69	375183.25

Section 'B'

NUMBER	DESCRIPTION	STATE PLANE COORDINATES	
		X	Y
1	48" DIA. C.M.P. OUTFALL	338573.05	380056.78
2	48" DIA. R.C.P. OUTFALL	338578.29	380058.83
3	24" DIA. R.C.P. OUTFALL	339378.93	380348.14
4	12" DIA. R.C.P. OUTFALL	339403.26	380335.39
5	15" DIA. R.C.P. OUTFALL	338082.92	379821.10

MS4 OUTFALL PIPE MAPPING
SECTION 'B' (EAST SIDE OF
THE RAILROAD TRACKS)

SECTION LINE
ALONG CONRAIL

MS4 OUTFALL PIPE MAPPING
SECTION 'A' (WEST SIDE OF
THE RAILROAD TRACKS)


Note:

THIS PLAN HAS BEEN PREPARED UTILIZING THE FOLLOWING INFORMATION:

- LOCATIONS OF INLET STRUCTURES LOCATED BY MR. KEN WILSON & MR. ERNIE RINK FROM THE BARRINGTON BOROUGH STORMWATER MANAGEMENT COMMITTEE.
- LOCATIONS OF OUTFALLS AND OUTFALL TYPE PROVIDED BY CAMDEN COUNTY PUBLIC WORKS DEPARTMENT. ADDITIONAL LOCATIONS OBTAINED BY KEI ASSOCIATES, P.A.
- GIS DATA AVAILABLE FROM THE STATE OF NEW JERSEY'S BUREAU OF GEOGRAPHIC INFORMATION SYSTEMS.

Legend

- ▲ 19 OUTFALL
- A-041 INLET

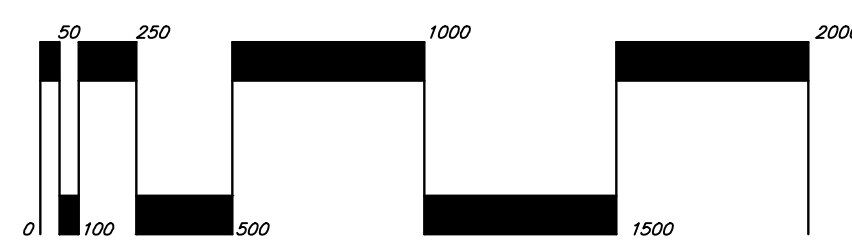

Graphic Scale
scale: 1 inch = 500 feet

REV.	DATE:	DESCRIPTION	DRWN.	CHKD.
2.	02/20/09	ADDED OUTFALL NUMBER 14		T.D.
2.	02/20/09	REVISED PER MARKUP PLAN FROM BOROUGH		M.F.
1.	4/3/07	ADDED OUTFALL NUMBER 25		T.D.

MS4 Outfall Pipe Mapping

Borough of Barrington
Camden County, New Jersey

DATE:	02/12/07	DRAWN BY:	T.D.	SCALE:	1" = 500'
CHKD. BY:		PROJECT No.:	11-242	FIELD BOOK/PAGE:#	
				SHEET No. 1 OF 1	



PROFESSIONAL ENGINEERS, LAND SURVEYORS AND PLANNERS
80 S. WHITE HORSE PIKE, BERLIN, NEW JERSEY 08009 (856) 767-6361
FAX: (856) 753-1091, www.keiassociates.com

REPRODUCTION, ALTERATION AND AMENDMENT OF THIS PLAN SHALL BE PERFORMED ONLY BY KEI ASSOCIATES, P.A. AND SHALL BE PERFORMED UNDER THE ABSOLUTE DIRECTION OF THE LICENSED PROFESSIONAL WHOSE NAME AND SIGNATURE APPEARS HEREON.